


PLAN

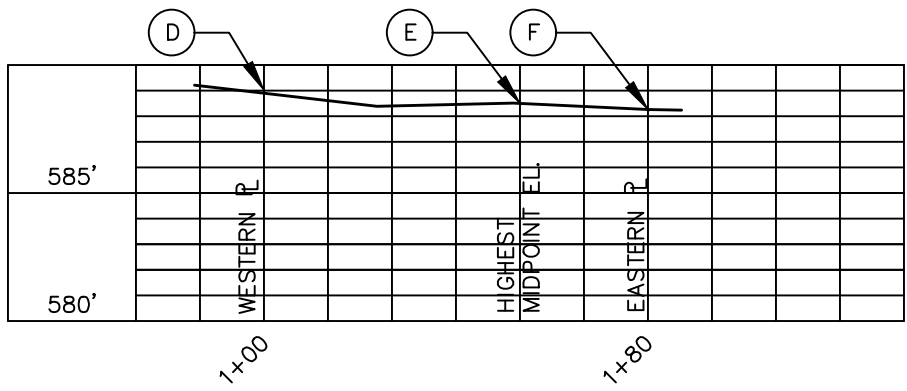

PROFILE A-A

LOW SILL ELEVATIONS:	ERS ELEVATIONS:	LOWEST SILL ELEVATION	=	XXX.XX
A - XXX.XX	D = XXX.XX	HIGHEST MIDPOINT ELEVATION	=	XXX.XX
B - XXX.XX	E = XXX.XX	FREEBOARD PROVIDED	=	XXX.XX
C - XXX.XX	F = XXX.XX			

$$\text{SLOPE} = \frac{\text{UPSTREAM ELEVATION} - \text{DOWNSTREAM ELEVATION}}{\text{LENGTH OF ERS}}$$

<p>City of Wentzville Public Works Department Engineering Division 200 East Fourth Street Wentzville, MO 63385</p>	<p><b>ASBUILT E.R.S. MEASUREMENTS</b></p>	05/03/2018
		SH 1